



COMMONWEALTH OF AUSTRALIA

*Sections 226 and 708  
Offshore Petroleum and Greenhouse Gas Storage Act 2006*

APPLICATION FOR VARIATION OF A PIPELINE LICENCE

I, **GRAEME ALBERT WATERS**, the National Offshore Petroleum Titles Administrator, on behalf of the Commonwealth–Victoria Offshore Petroleum Joint Authority hereby give notice pursuant to sections 226 and 708 of the *Offshore Petroleum and Greenhouse Gas Storage Act 2006* that an application has been received from

**Esso Australia Resources Pty Ltd**  
(ABN 62 091 829 819)

**BHP Billiton Petroleum (Bass Strait) Pty. Ltd.**  
(ABN 29 004 228 004)

for the variation of Pipeline Licence VIC/PL14 in the offshore area of Victoria, as set out below.

Pursuant to subsection 226(3) of the Act, a person may make a written submission to the Titles Administrator about this application within 30 days from the date of this notice.

This notice takes effect on the day on which it appears in the  
*Australian Government Gazette.*

Made under the *Offshore Petroleum and Greenhouse Gas Storage Act 2006*  
of the Commonwealth of Australia.

**GRAEME ALBERT WATERS**  
TITLES ADMINISTRATOR  
ON BEHALF OF THE COMMONWEALTH–VICTORIA  
OFFSHORE PETROLEUM JOINT AUTHORITY

**APPLICATION FOR VARIATION OF  
PIPELINE LICENCE VIC/PL14**

The application seeks to affect the following administrative amendments to the licence:

Pipeline Duration, Interpretation and Conditions

1. Vary the duration of the licence from a fixed term to an indefinite term to reflect legislative amendment.
2. Where possible, remove references in the licence to the former Designated Authorities or the 'said Director'.

Route of the Pipeline

3. Add the As-Constructed Pipeline Co-ordinates.
4. Add the Route Map.

Specifications and Further Conditions



5. Update the pipeline design details and parameters, including reference to relevant Australian Standards, to reflect the as-constructed West Kingfish to Kingfish A pipeline.
6. Delete conditions relating to pipeline specifications, performance, reporting and approval requirements that are no longer required or have been superseded under the current regulatory regime (and are regulated by the National Offshore Petroleum Safety and Environmental Management Authority).

As-Constructed Pipeline Co-ordinates

The route of the West Kingfish to Kingfish A pipeline is described in the table below, and displayed in the map below, commencing at the flange immediately downstream of the Last Valve Off (LVO) on the West Kingfish platform and terminating at the first flange upstream of the First Valve On (FVO) on the Kingfish A platform. Coordinated are based on Geodetic Datum of Australia (GDA94).

POINT ID	DESCRIPTION	EASTING	NORTHING
1	LVO West Kingfish Manifold	596271.01	5727813.48
2	Inflection Point 01	596260.21	5727814.31
3	Inflection Point 02	596257.77	5727779.37
4	Inflection Point 03	599124.17	5727640.06
5	Inflection Point 04	599531.42	5727775.81
6	Inflection Point 05	599674.06	5727421.47
7	Inflection Point 06	599683.96	5727418.78
8	Inflection Point 07	599683.32	5727405.55
9	FVO Kingfish A Manifold	599673.34	5727406.28

Coordinate set above is based on GDA94 / MGA Zone 55, survey of pipeline centreline.

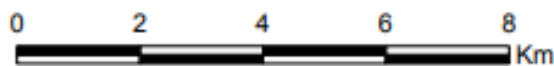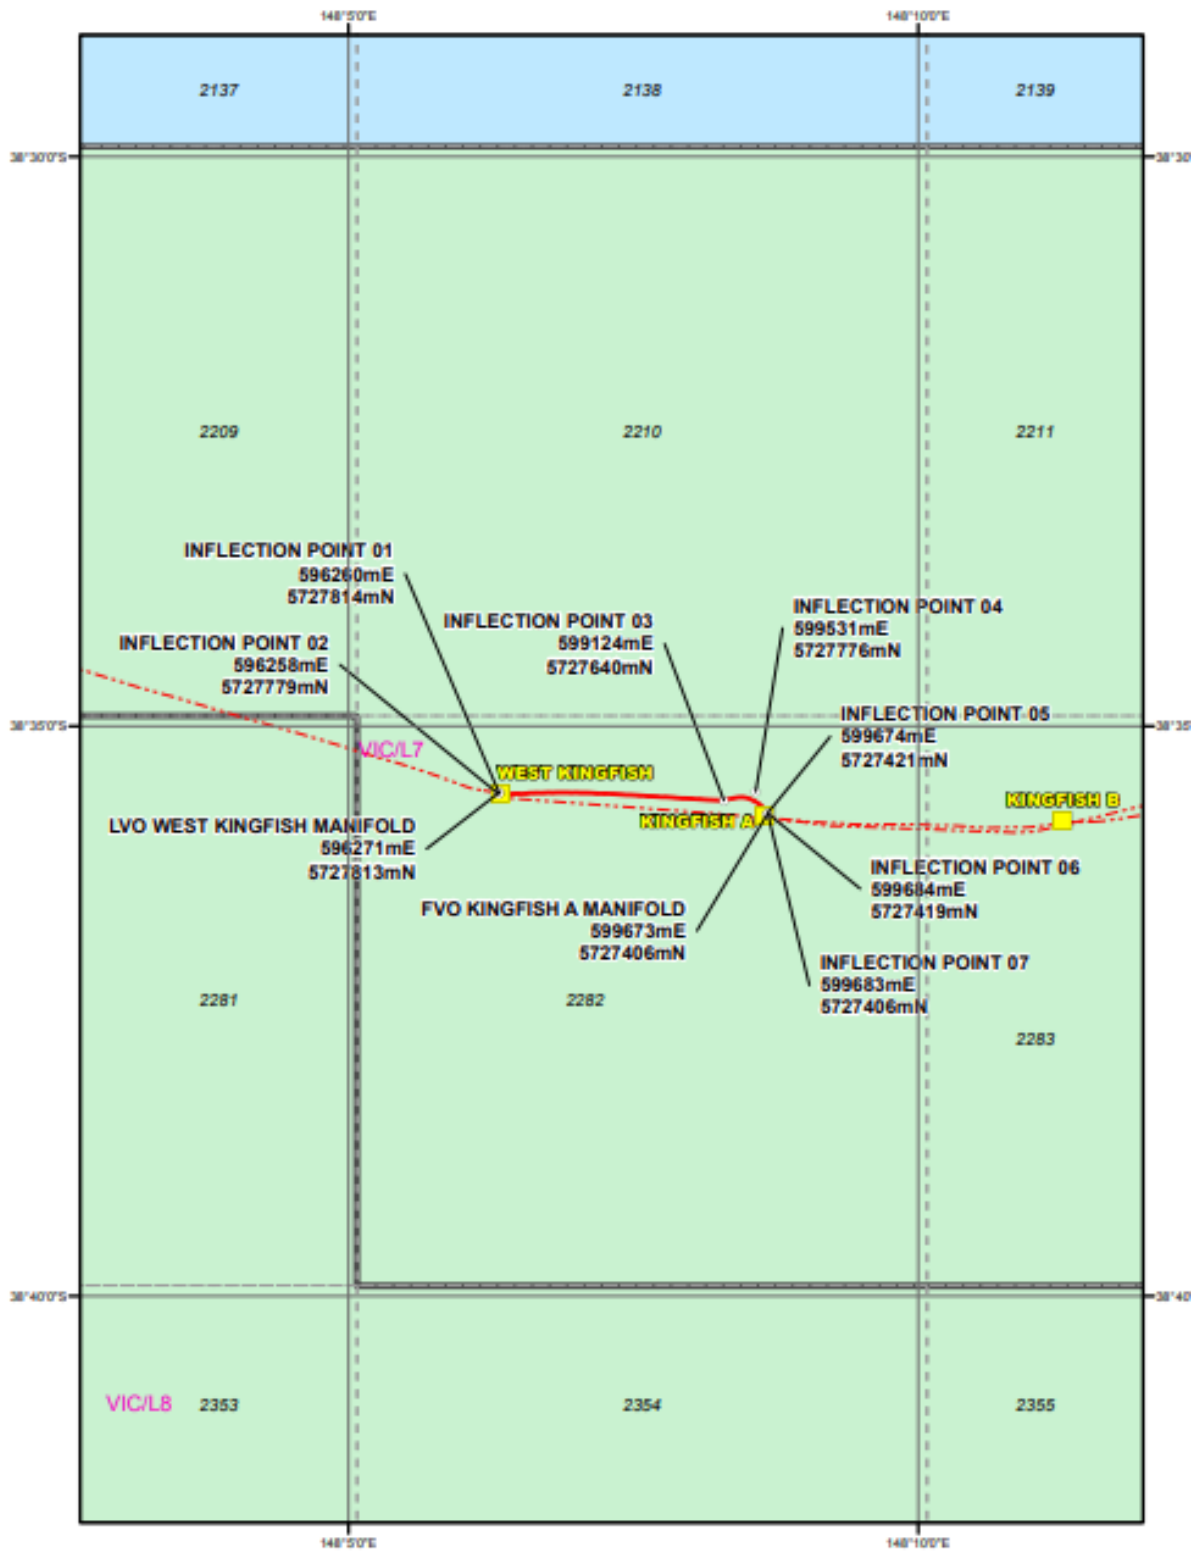

GDA94 Coordinates

**Legend**

- Platform
- VIC/PL14 (WKF300 Pipeline)
- - - Other Pipelines
- - - 3nm Limit
- Graticular Block
- Permit